



TRANSWESTERN®

500 Ygnacio Valley Road
Suite 100
Walnut Creek, Ca 94596
T (925) 357-2000
F (925) 357-2001

LEASING AGENTS

Scott Ellis
(925) 357-2005

Matt Hurd
(925) 357-2013

Growers Square

1646 N. California Blvd.
Walnut Creek, CA 94596

Fourth Floor

Owned by:
Growers Square, Inc.

Managed by:

CB Richard Ellis

Approximate Area Calculations
Subject To Verification:


3,470 rsf

As-built Plan To Be Verified


This information displayed while not guaranteed has been secured by sources we believe to be reliable. This information is subject to errors & omissions. Any tenant should conduct their own investigation.

Plan Revision - 10-8-15

SUITE FLOOR LOCATION

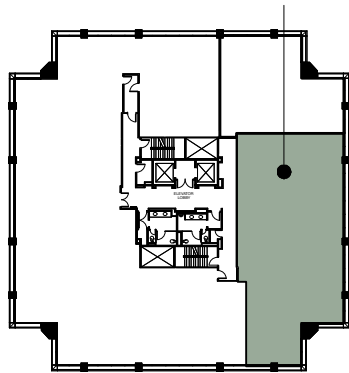

KEY PLAN 1646 BLDG - 4TH FLOOR

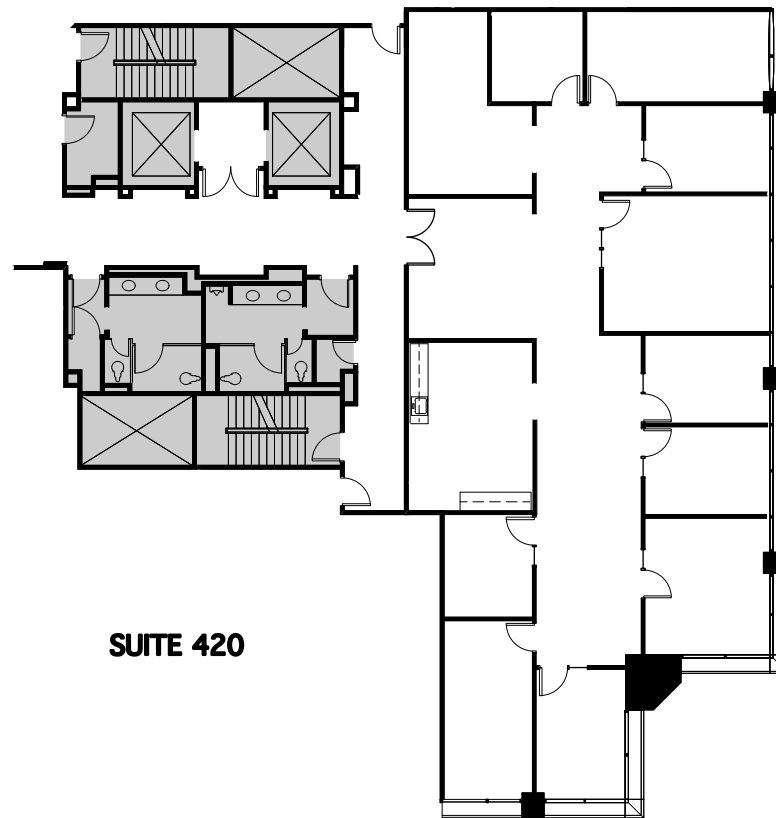

SUITE 420