



SUITE 440

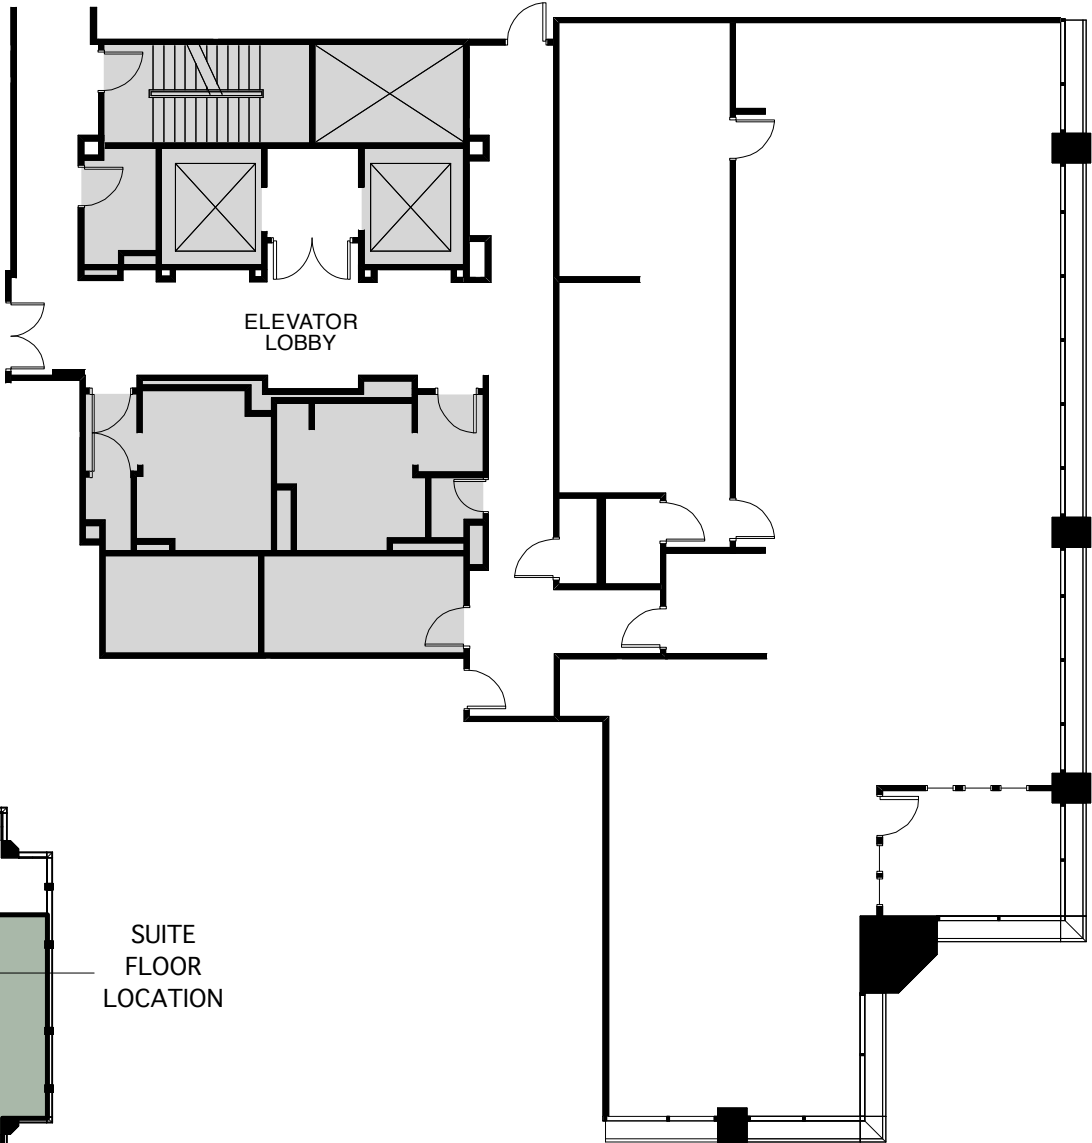

ELEVATOR LOBBY

SUITE FLOOR LOCATION

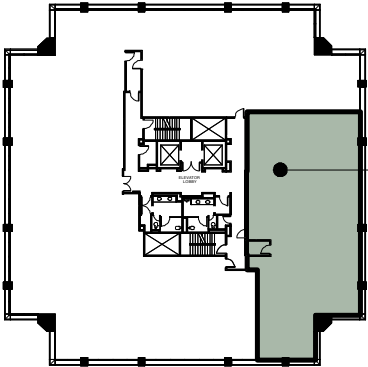

KEY PLAN 1646 BLDG - 4TH FLOOR

Leased by



500 Ygnacio Valley Road
Suite 300
Walnut Creek CA 94596

Voice: (925) 939-3500
Fax: (925) 935-6895

Scott Ellis
(925) 274-2427

Trigger Reital
(925) 274-2426

GROWERS SQUARE

Walnut Creek, CA
Fourth Floor

Owned by:
Growers Square, Inc.

Managed by:
CB Richard Ellis

APPROXIMATE AREA CALCULATIONS
SUBJECT TO VERIFICATION:

3,470 RSF

AS-BUILT PLAN
TO BE VERIFIED

THIS INFORMATION DISPLAYED WHILE NOT
GUARANTEED HAS BEEN SECURED BY SOURCES WE
BELIEVE TO BE RELIABLE. THIS INFORMATION IS
SUBJECT TO ERRORS & OMISSIONS. ANY TENANT
SHOULD CONDUCT THEIR OWN INVESTIGATION.